

Fig 1: RAF Cosford site as-built plan

Showing the airfield with runway, the main dispersed aircraft storage sites situated around the perimeter track, No.2 School of Technical Training, and the Regional Hospital.

# RAF Cosford Dispersed Hutted Camps

Based on AM Drawing 4244/44


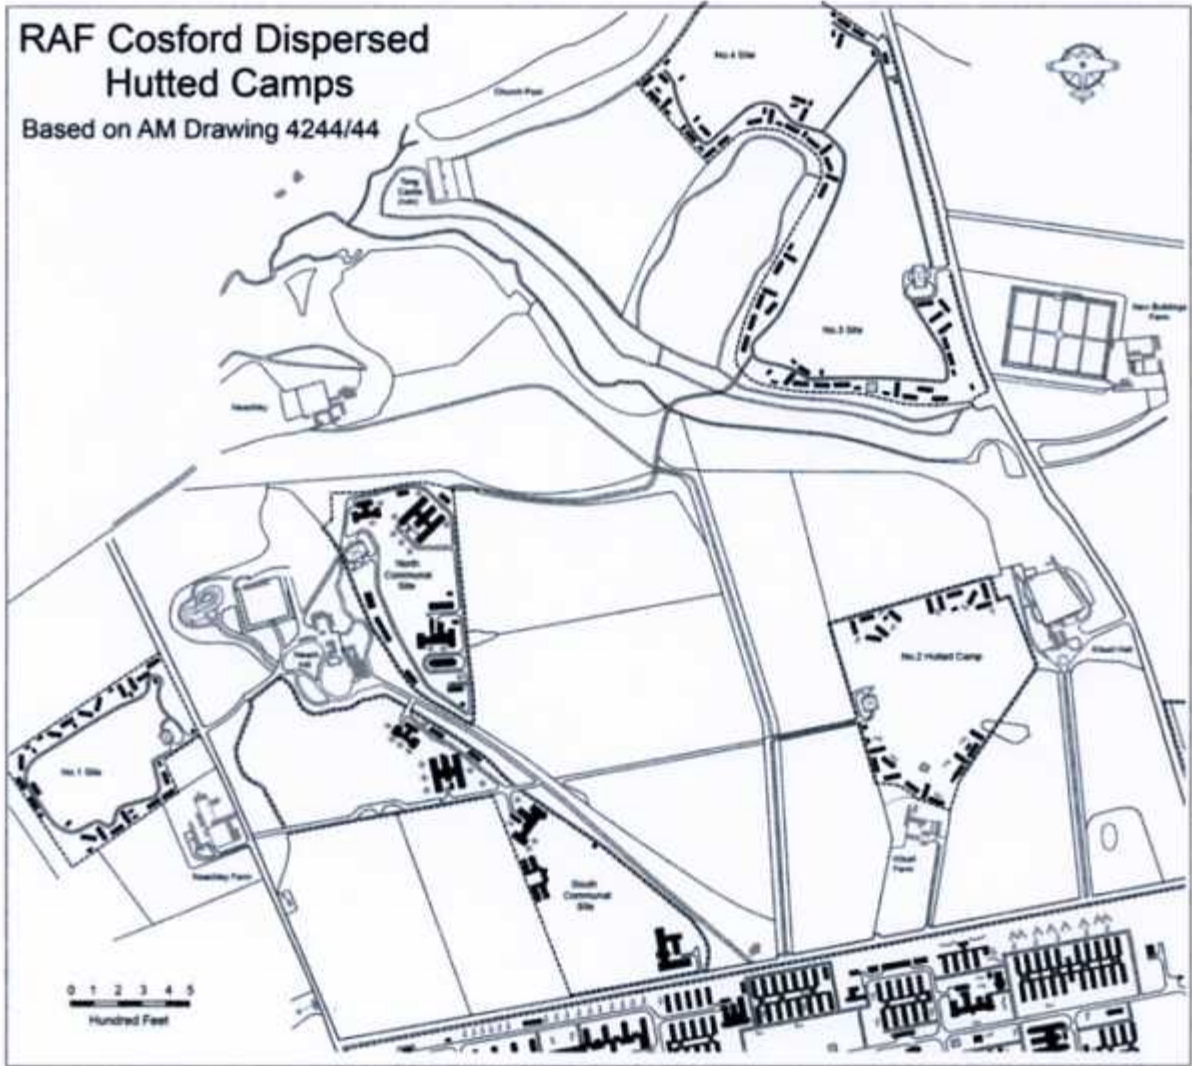


Fig 2: RAF Cosford dispersed hutted camps

This plan shows the locations of all of the dispersed domestic sites which were all built north of No.2 School of Technical Training. Only one building is known to be extant



Plate 2: Sergeants' mess on South Communal Site 25-11-11

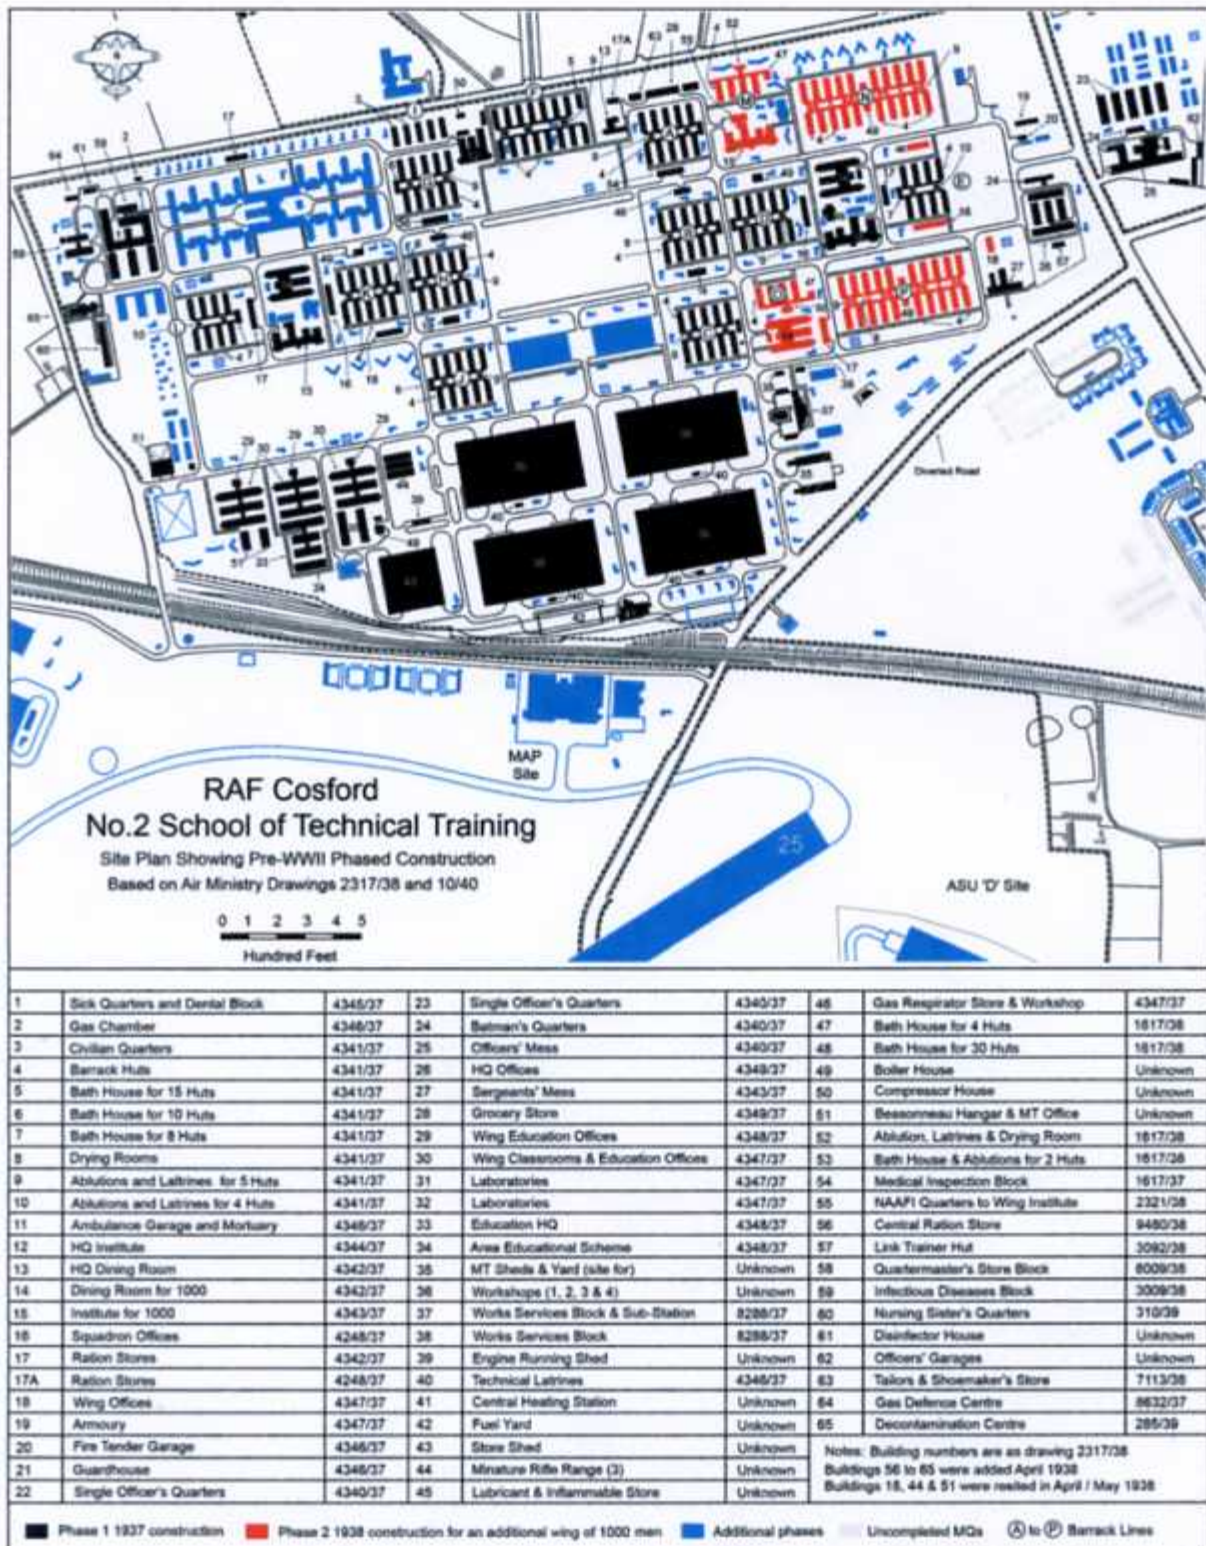

### Phased Pre-WWII planning

Sir Alfred Mc Alpine & Son Ltd won the contract and subsequent extensions for the construction of RAF Cosford and work started in February 1938. It was the first job for the company's southern division.

The following extract is based on No.2 School of Technical Training ORB (AIR 29/727). It covers the period July 1938 to December 1940, when the ORB was individually compiled by the various wings and schools. After that date, the entries are far less detailed.